

FOUNDATION LOCATION SURVEY

- of -

LOT 145 IN MILL CREEK NEIGHBORHOOD Y, BEING A SUBDIVISION IN PART OF THE EAST HALF OF SECTION 11, AND PART OF THE WEST HALF OF SECTION 12, TOWNSHIP 39 NORTH, RANGE 7 EAST OF THE THIRD PRINCIPAL MERIDIAN, ACCORDING TO THE PLAT THEREOF RECORDED AUGUST 8, 2006 AS DOCUMENT No. 2006k086108IN KANE COUNTY, ILLINOIS.


SYMBOLS LEGEND	
	Sanitary Sewer Manhole
	Storm Sewer Manhole
	Catch Basin
	Curb Inlet
	Fire Hydrant
	Water Valve In Vault
	Water Valve
	B-Box
	Light Pole
	Electric Transformer
	Utility Pedestal
	Storm Sewer
	Sanitary Sewer
	W—W—Watermain
	E—E—Underground Electric Line
	T—T—Underground Telephone Line
	TV—TV—Underground Cable Television

	As-built Contour Line
	Proposed Contour Line
	Proposed Finish Spot Grade
	Existing / As-built Spot Grade
	Proposed Drainage Flow Direction
	Indicates 90° Angle
	Building Setback Line
	Easement Line

NOTES
 "B.L." = Building Line
 "U.E." = Utility Easement
 "D.E." = Drainage Easement
 "D.U.E." = Drainage & Utility Easement

Neither the placement of boundary monumentation, nor witness points were a condition of this survey.

BENCHMARKS:	
①	SQUARE CUT IN CONCRETE CURB OPPOSITE FIRE HYDRANT AT LOT 37 MILL CREEK NEIGHBORHOOD A PHASE 1 ELEVATION = 734.38
②	P.K. SPIKE AT CENTERLINE INTERSECTION OF BOYD DRIVE AND ARMSTRONG LANE IN THE MILL CREEK SUBDIVISION. ELEVATION = 725.65
③	KANE COUNTY BENCHMARK. DESIGNATION 2-55 LOCATED IN SEC. 6 T. 39N R.8E NATIONAL GEODETIC VERTICAL DATUM OF 1929. ELEVATION = 719.18

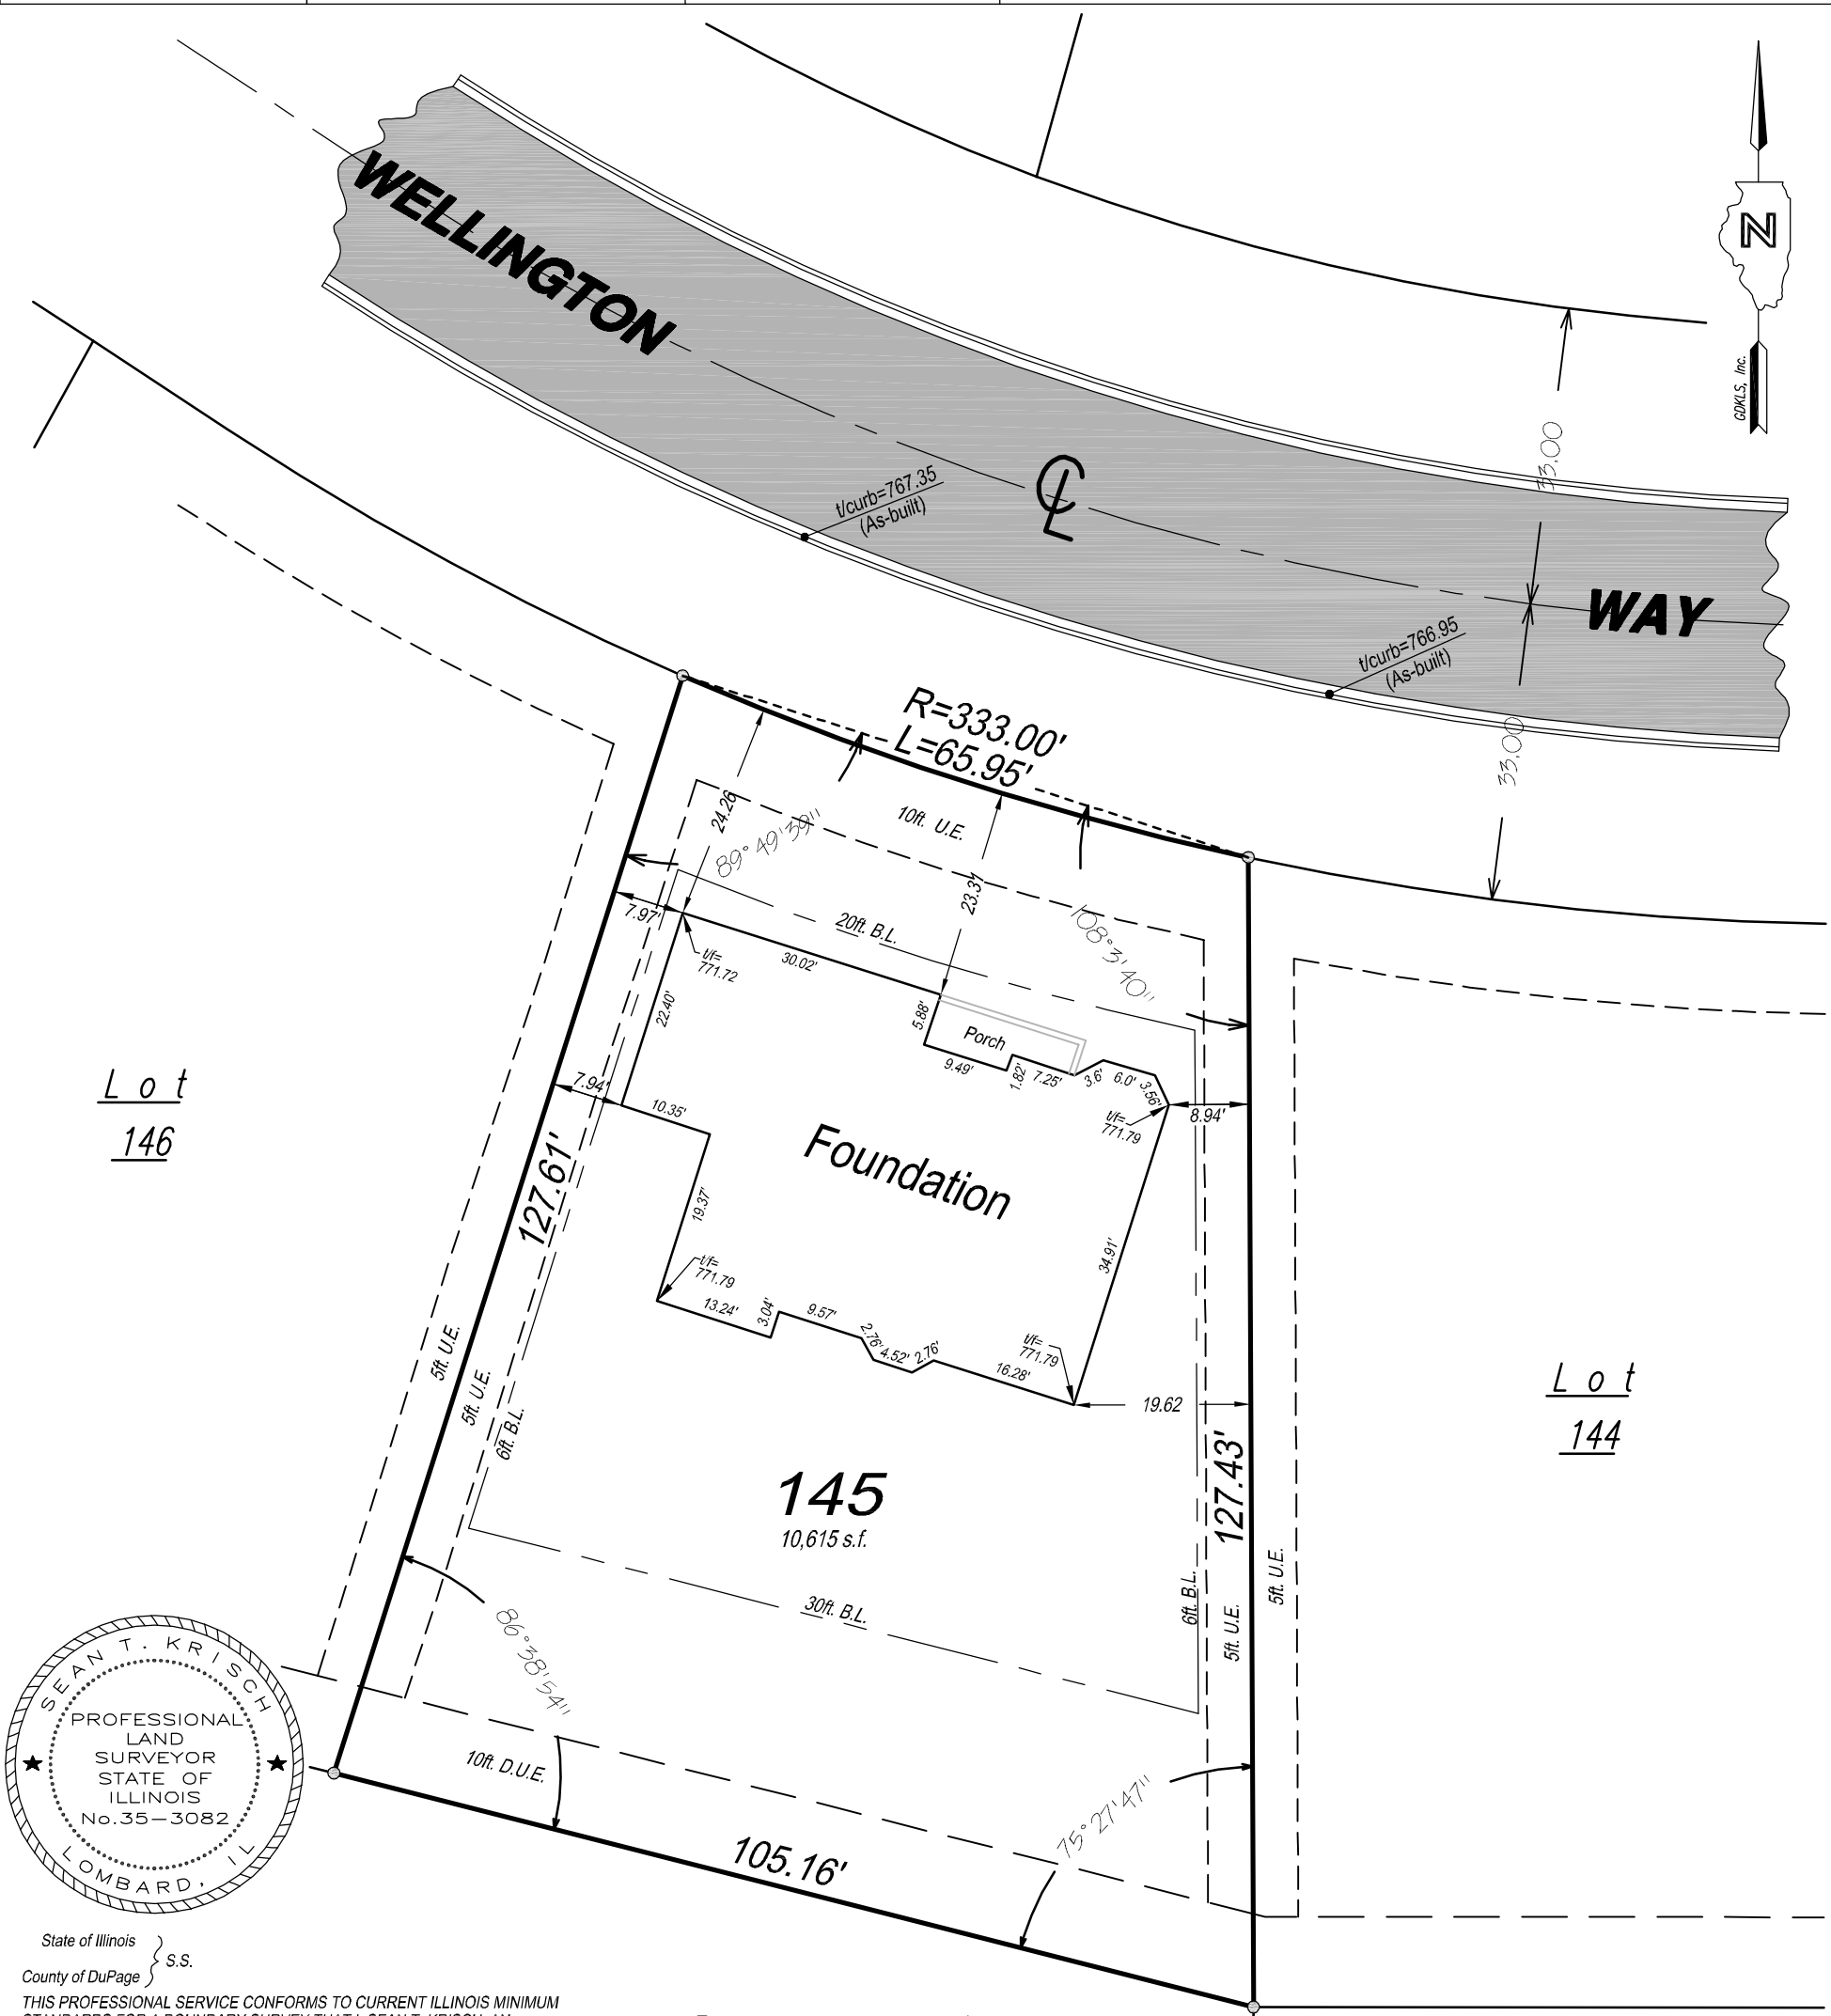


Lot
146

Lot
144




State of Illinois } s.s.
 County of DuPage }
 THIS PROFESSIONAL SERVICE CONFORMS TO CURRENT ILLINOIS MINIMUM STANDARDS FOR A BOUNDARY SURVEY THAT I, SEAN T. KRISCH, AN ILLINOIS PROFESSIONAL LAND SURVEYOR, HAVE HAD SURVEYED UNDER MY SUPERVISION THE PROPERTY DESCRIBED IN THE ABOVE CAPTION AS SHOWN BY THE ANNEXED PLAT WHICH IS A REPRESENTATION OF SAID SURVEY.
 Given under my hand and seal at Lombard, Illinois, this 20th day of February A.D. 2009.

Prepared For:
SHO-DEEN, Inc.
 (630) 232-8570

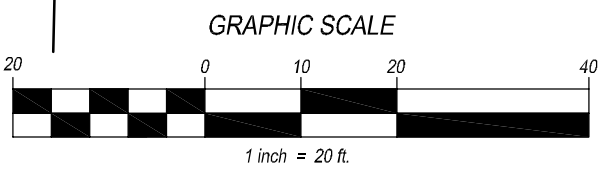

Sean T. Krisch
 Illinois Professional Land Surveyor No. 35-3082.
 My License Expires November 30, 2010.

- Refer to deed or guarantee policy for building line restrictions and easements not shown on plat of survey.
- Compare description and points before building and report any apparent difference to the surveyor at once.
- This survey and plat of survey are void without our embossed surveyor seal shown hereon.
- No dimensions are to be assumed by scaling.

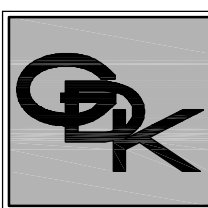

No.	Date	Revision Description	By:

GLEN D. KRISCH LAND SURVEYOR, Inc.
 PROFESSIONAL DESIGN FIRM LICENSE No. 184-004233
 1716 South Finley Road • Lombard, IL 60148 • Phone: 630.627.5589
 Fax: 630.627.5594
SURVEYING - CONSULTING - CONSTRUCTION LAYOUT
 Scale: 1"=20' Drawn: MLO Chk'd: STK GDK File# 05-015 CAD File: 05-015-Y145.dwg